



PRIMARY SHOWER HOUSE ROAD

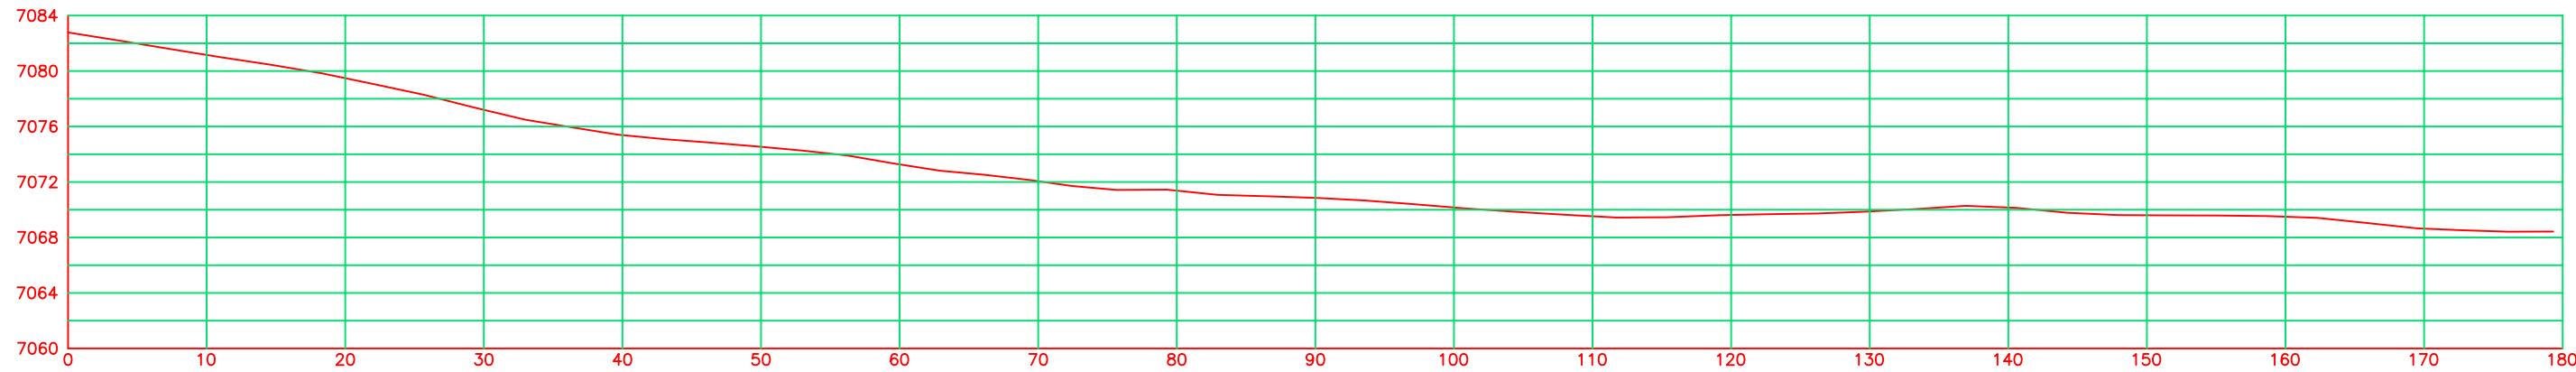


PROFILE

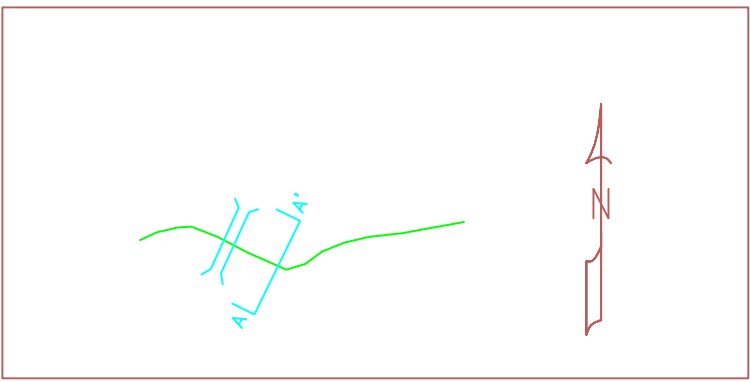

PLAN VIEW


1" = 100'

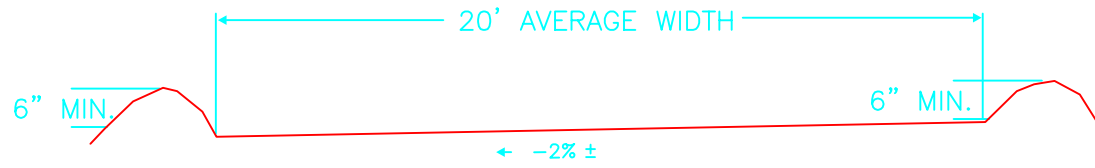


TYPICAL CROSS SECTION A-A'

SCALE: 1" = 5'

PRIMARY TANK SEAM ROAD

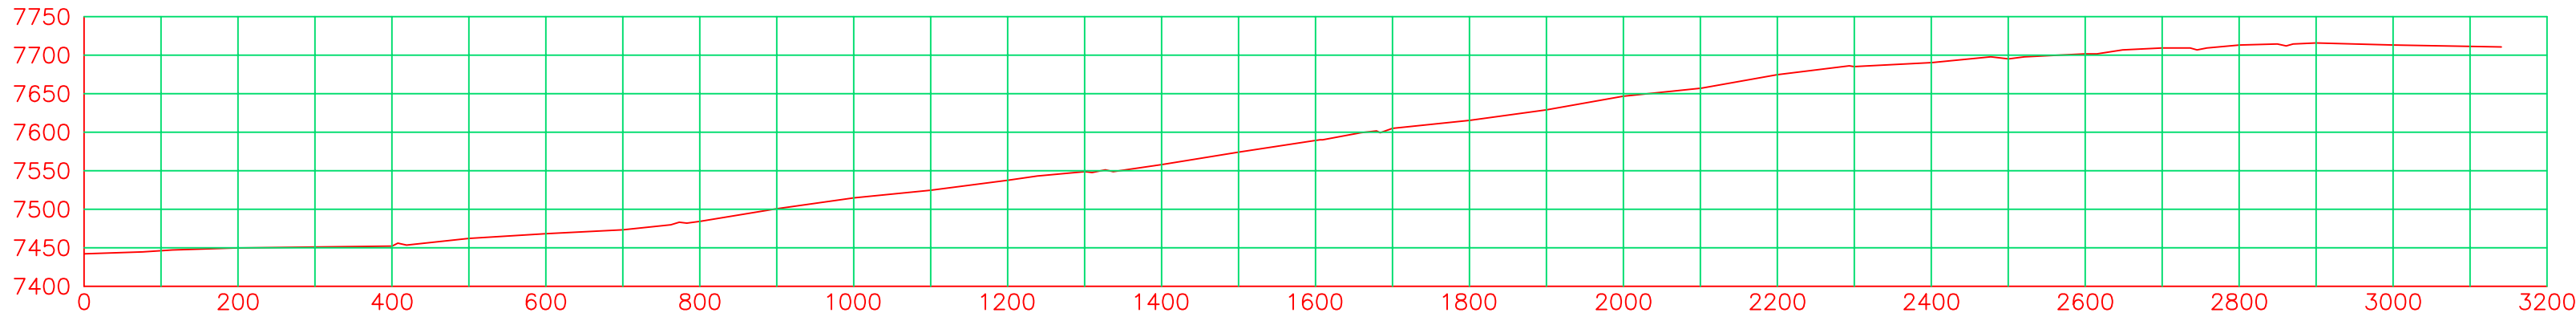


PROFILE

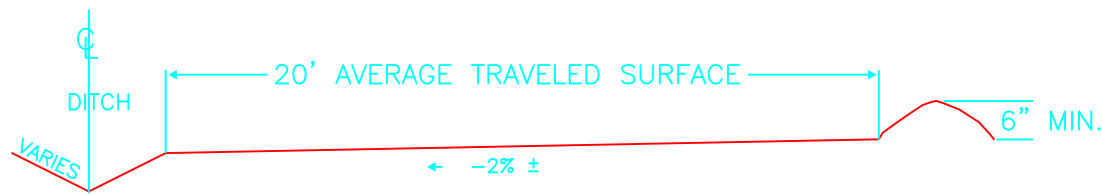

TYPICAL CROSS SECTION B-B'


SCALE: 1" = 5'

NOTE: Roads are crowned as shown. Actual dimensions and slopes may vary on surface.

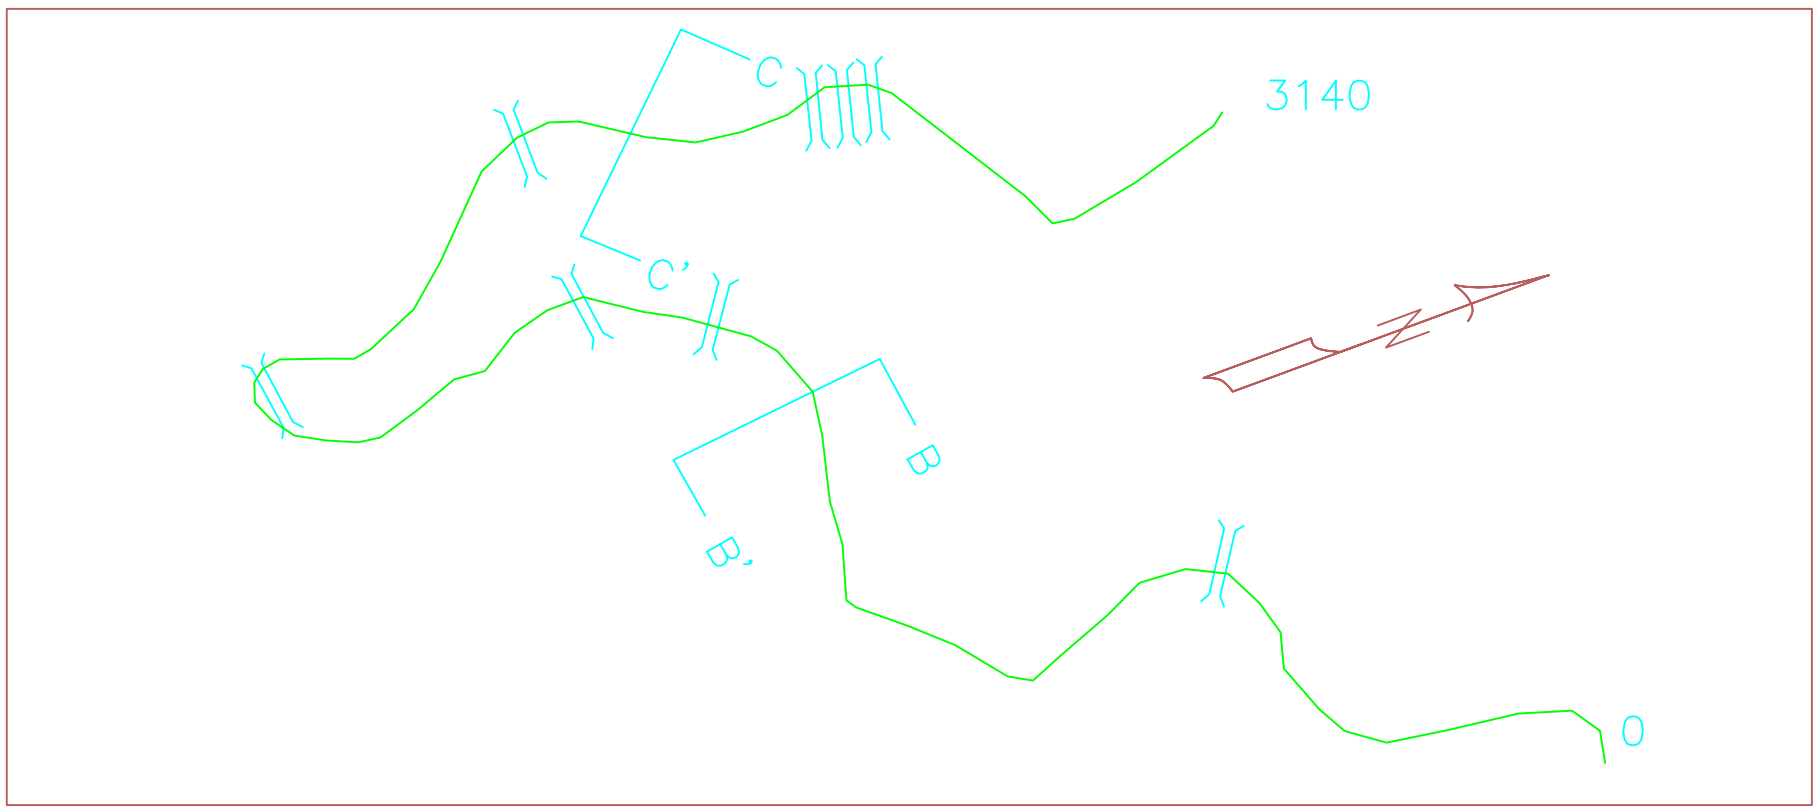

PLAN VIEW

1" = 200'

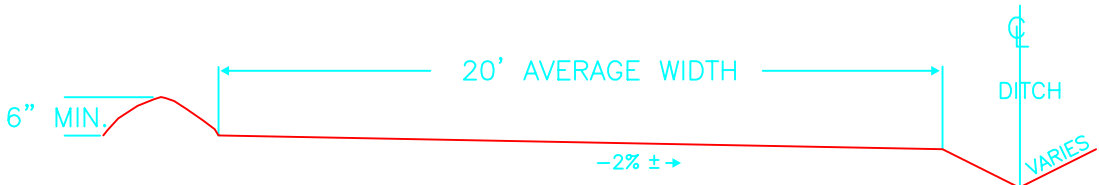

TYPICAL CROSS SECTION C-C'

SCALE: 1" = 5'

SEE PLATES 2-4 FOR SURFACE FACILITIES  
SEE PLATES 7-1 FOR HYDROLOGY  
SEE TABLE 7.2-10 FOR DIVERSION CHARACTERISTICS

REV.	DATE	REMARKS	APPR.
1	11/20/92	Shower House Road Design (92H)	2/09/93
2	10/22/93	Tank Seam Road Design Added (93B)	7/22/94
3	2/23/96	Tank Seam As-Built Road Added (96A)	7/05/96
4	8/01/02	Changed name from 3-5C to 5-4C	
5			
6			
7			
8			
9			
10			

CO-OP MINING CO.		
HUNTINGTON, UTAH		
ROAD - DETAILS		
SCALE: AS SHOWN	DRAWN BY: C. Reynolds	DATE: 11-20-92
BEAR CANYON		PLATE 5-4C